


J:\Highwoods\2.210274.0 - HPI-Seaside-Ste 805 Survey\3 Design\06 CADD\ID\Highwoods - Seaside Plaza - Suite 805 - As Built.dwg 5/5/2021 3:36 PM Natalie Uliano



Seaside Plaza - Suite 805
As Built

May 5, 2021

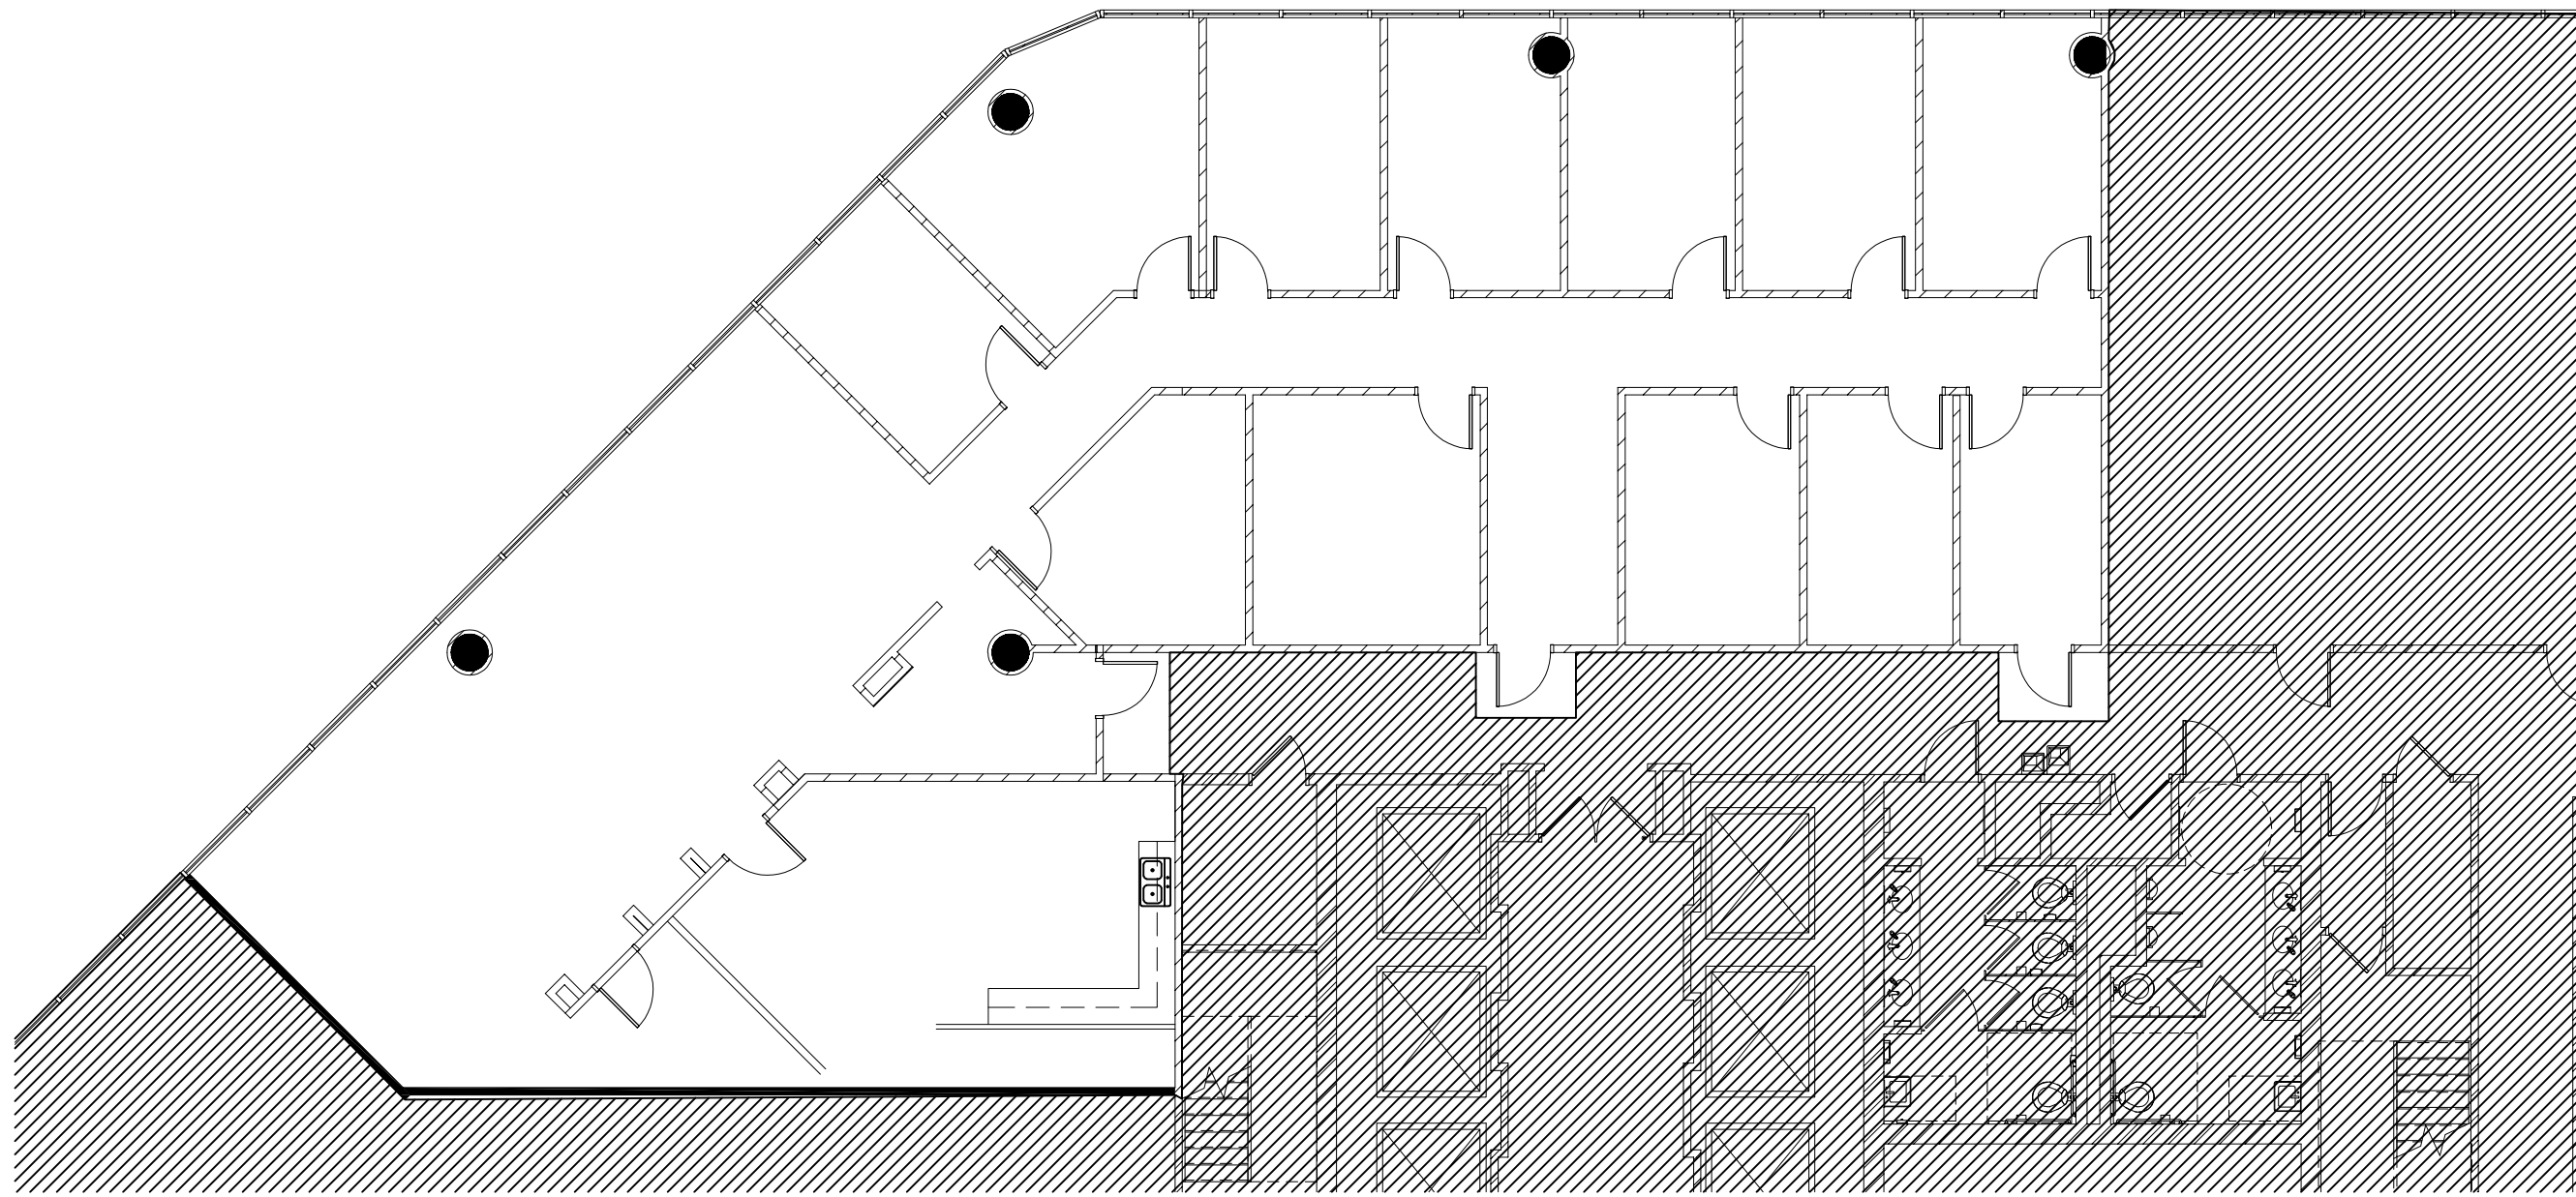